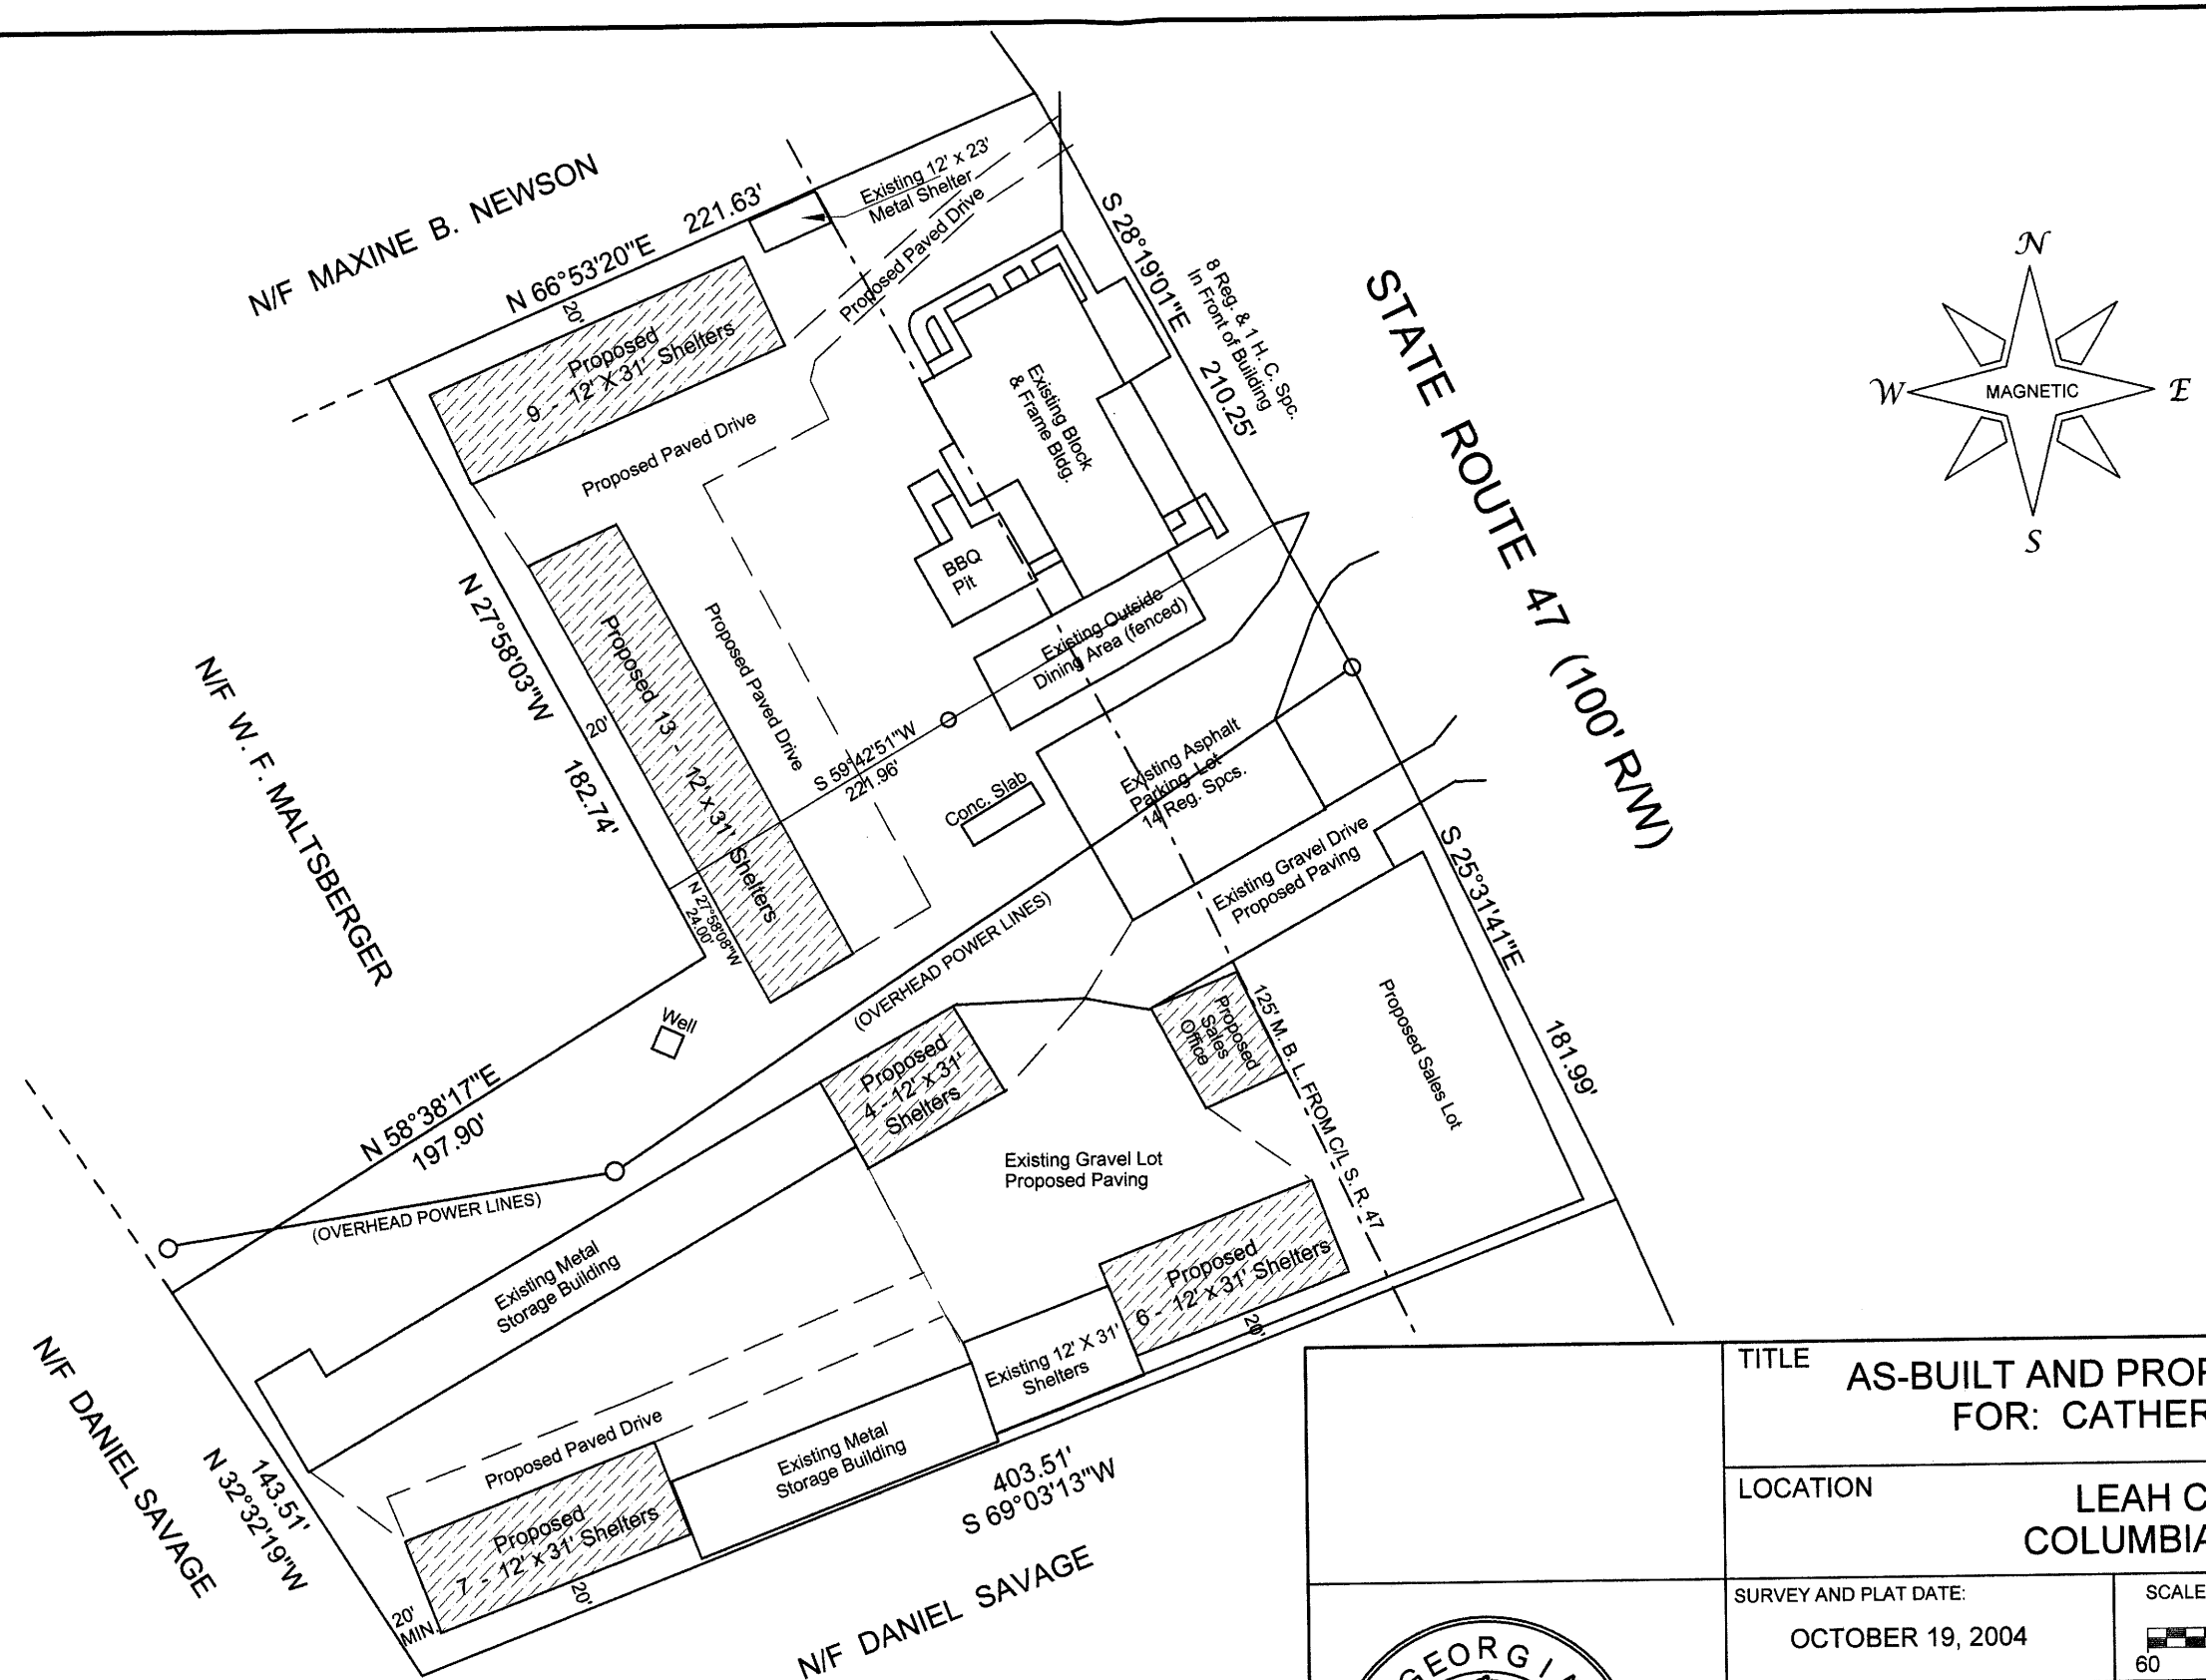

TITLE

AS-BUILT AND PROPOSED SITE LAYOUT PLAN FOR: CATHERINE A. WALTON

LOCATION

LEAH COMMUNITY COLUMBIA COUNTY, GA.

SURVEY AND PLAT DATE:

OCTOBER 19, 2004

SCALE: 1" = 60'

60 0 60 120

GEORGIA REGISTERED No. 2394 LAND SURVEYOR JOHN E. DYKES, JR.

THIS FIELD SURVEY AND PLAT WAS PREPARED AT THE REQUEST OF AND FOR THE EXCLUSIVE USE OF THE OWNER(S) OF THIS PROPERTY AS SHOWN IN THE TITLE BLOCK.

NOTE: THIS PROPERTY MAY ALSO BE SUBJECT TO EASEMENTS, SETBACKS OR REGULATIONS NOT SHOWN ON THE PLAT BUT MAY BE ON RECORD IN THE CLERK OF SUPERIOR COURT'S OFFICE.

PREPARED BY: JOHN E. DYKES, JR, R.L.S.
DYKES & ASSOCIATES
4571 - C COX ROAD EVANS, GA. 30809
706 - 855 - 0577

04-